


**REAR GRADING PLAN**  
SCALE: 3/16"=1'-0"

**LEGEND**

- EXISTING GRADE ELEVATION
- PROPOSED NEW GRADE ELEVATION
- PERMEABLE PAVERS, ON 2" CRUSHED STONE BEDDING, ON 6" CRUSHED NATURAL STONE BASE COURSE, ON 12" NATURAL STONE SUB-BASE COURSE, ON GEOTEXTILE SEPARATOR-WOVEN, ON EXISTING SOIL.
- LANDSCAPE MATERIALS IN 14" COMPOST, OVER STABILIZATION TEXTILE, OVER EXISTING SOIL.
- TURF SLAB PERMEABLE PAVERS, OVER 6" CRUSHED NATURAL STONE BASE COURSE, OVER 12" NATURAL CRUSHED STONE SUB-BASE COURSE, OVER GEOTEXTILE SEPARATOR-WOVEN, OVER EXISTING SOIL.
- EXPOSED AGGREGATE 4" CONCRETE, ON 6" CRUSHED NATURAL STONE BASE COURSE, ON EXIST. SOIL.
- 6" COMPACTED CRUSHED STONE, OVER 6" CRUSHED NATURAL STONE BASE COURSE, OVER GEOTEXTILE SEPARATOR-WOVEN, OVER EXISTING SOIL.

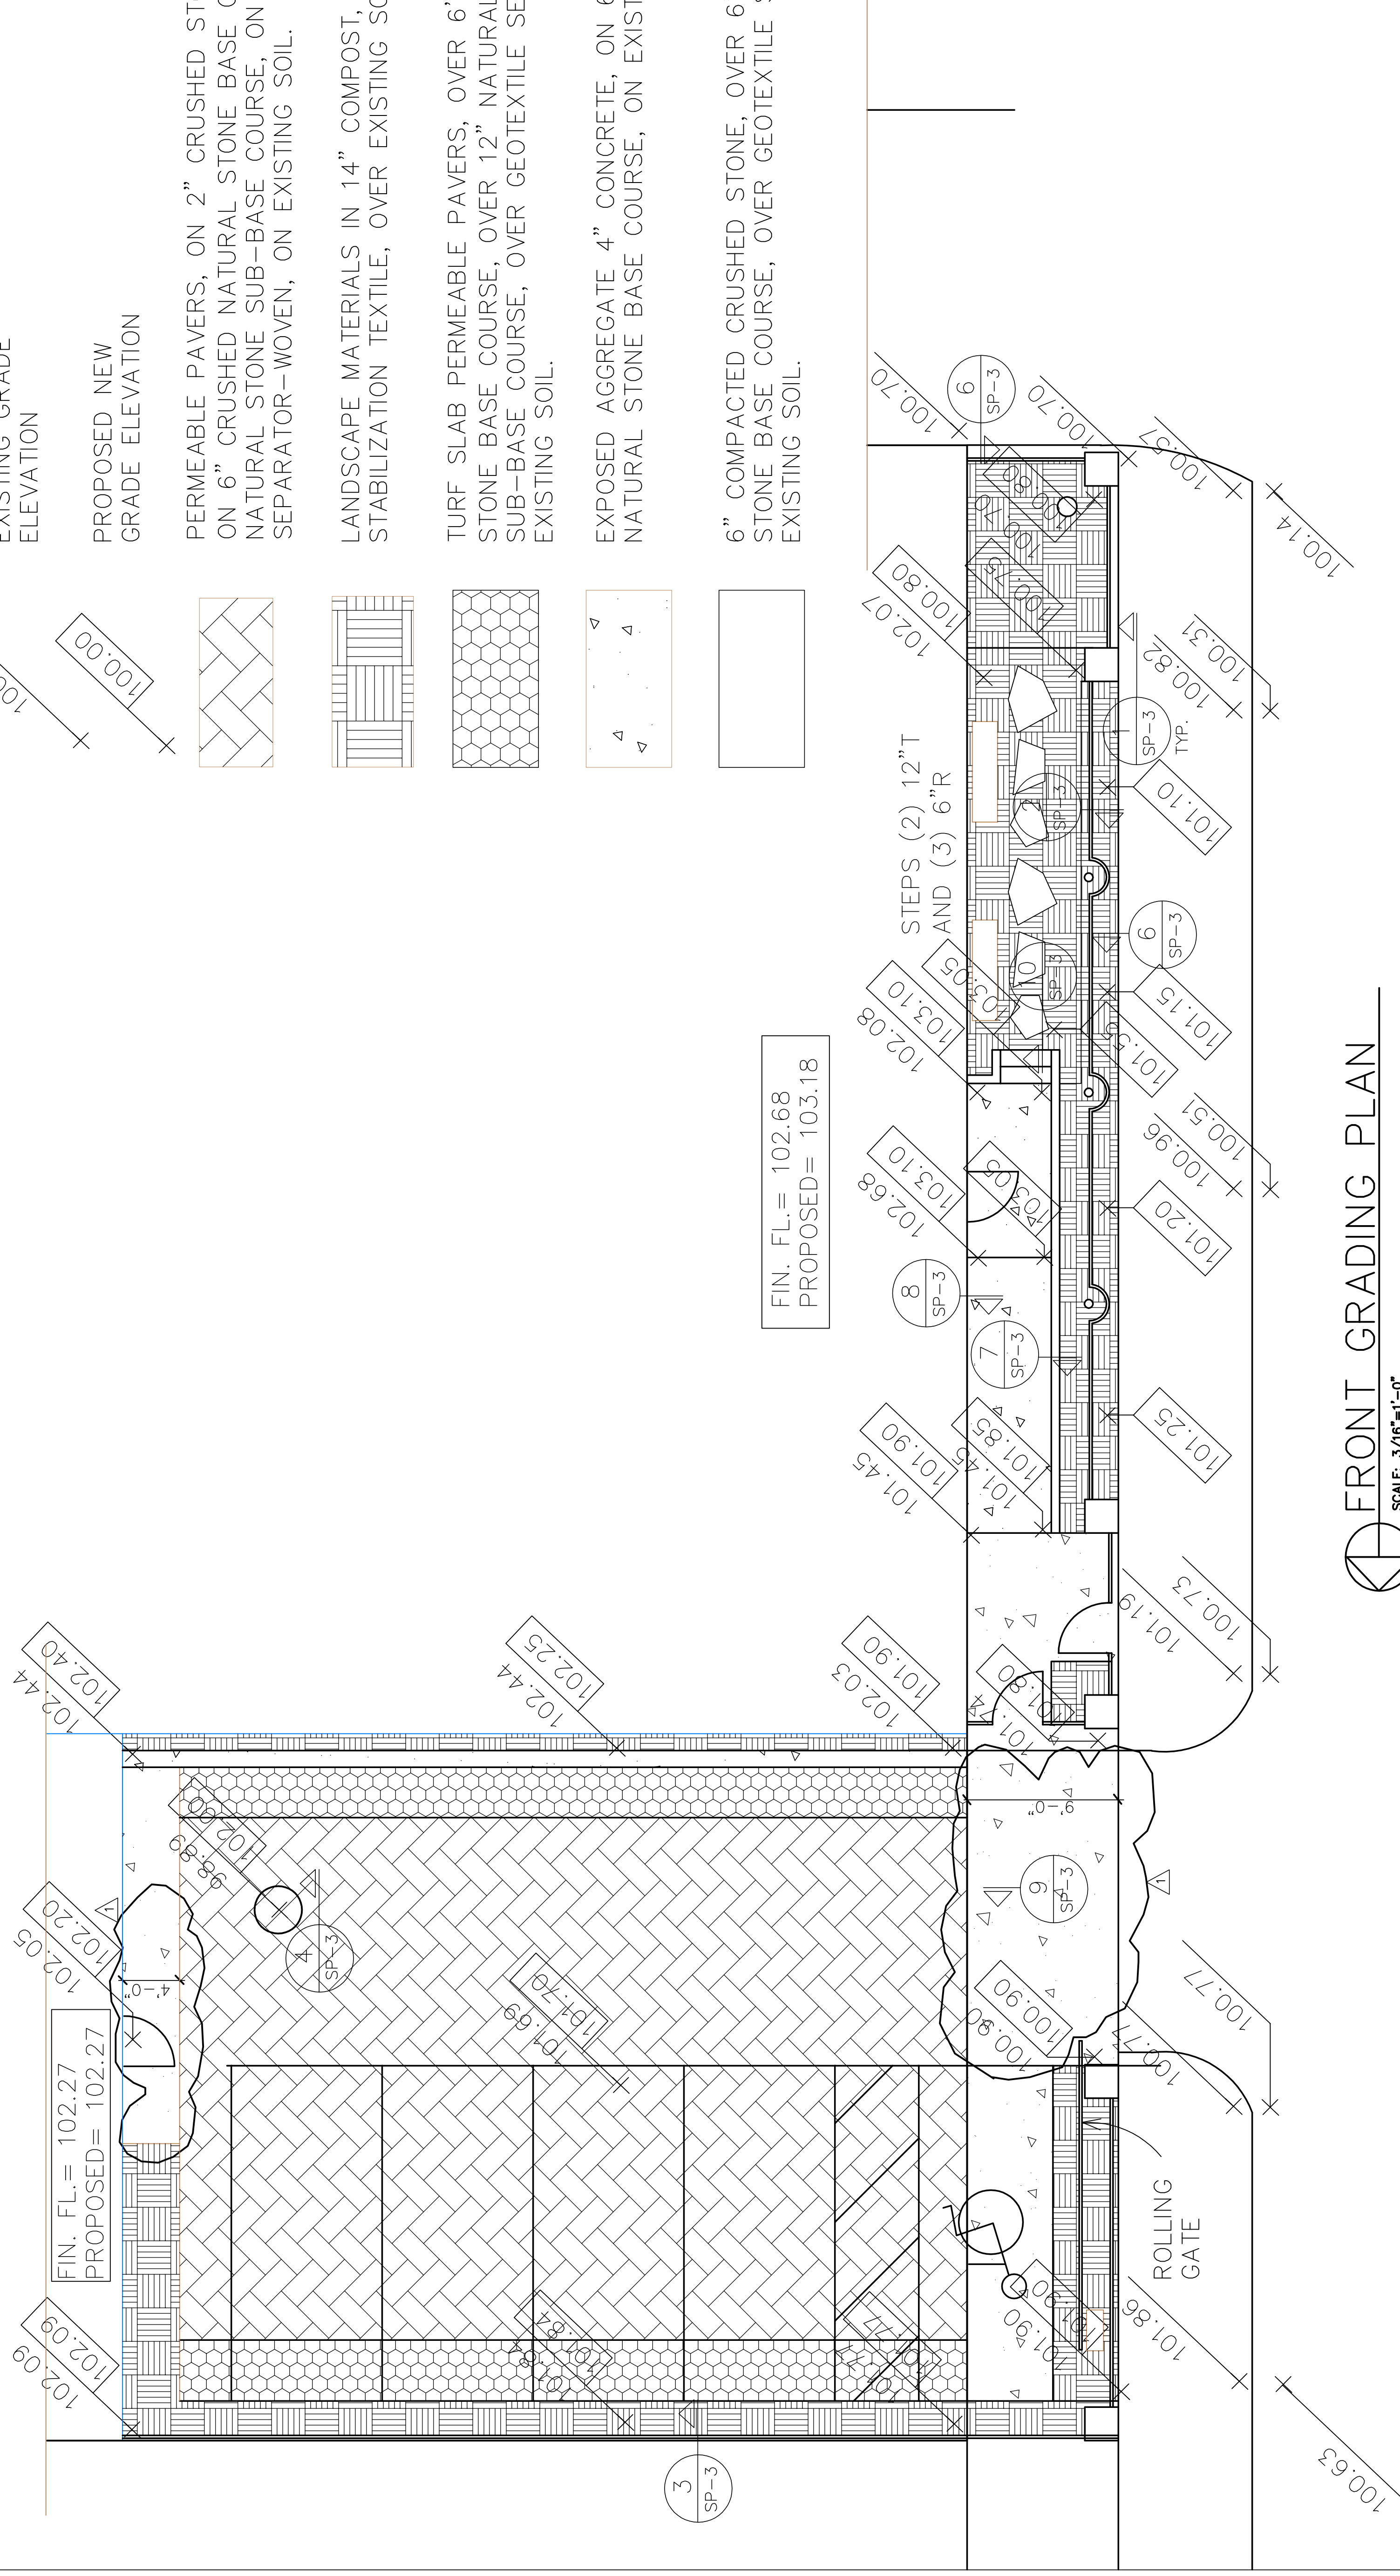

**FRONT GRADING PLAN**  
SCALE: 3/16"=1'-0"



11-8-10	CONSTRUCTION OF FRONT YARD				
8-27-09	REVISED PER CITY FOR PERMIT				
7-30-09	OWNER REVIEW				
	ISSUE FOR				
	DATE				
	BY				
	BULLETIN				
	REVISIONS				

GREEN GARAGE AS BUILT  
GREEN GARAGE RENOVATION  
4444 SECOND AVENUE  
DETROIT, MI 48201

Architects **Planners Engineers**  
**INTERNATIONAL INC.**  
17400 Warren  
Warren, MI 48091  
Phone: 313-341-7930  
Fax: 313-341-6944

DESIGNED	TLB	CHECKED	TLB	PROJECT NO.	0923
DRAWN	TLB	APPROVED	TLB	DATE	7-30-09
SHEET TITLE				SHEET NO.	SP-2